


SERVICES ARE IN THE STRATA UNLESS OTHERWISE NOTED

REFERENCE DRAWINGS			
STRUCT			
MECH			
ELEC			
ROF			
ARCH			
DISCIPLINE	DRAWING NUMBER	REV	DATE

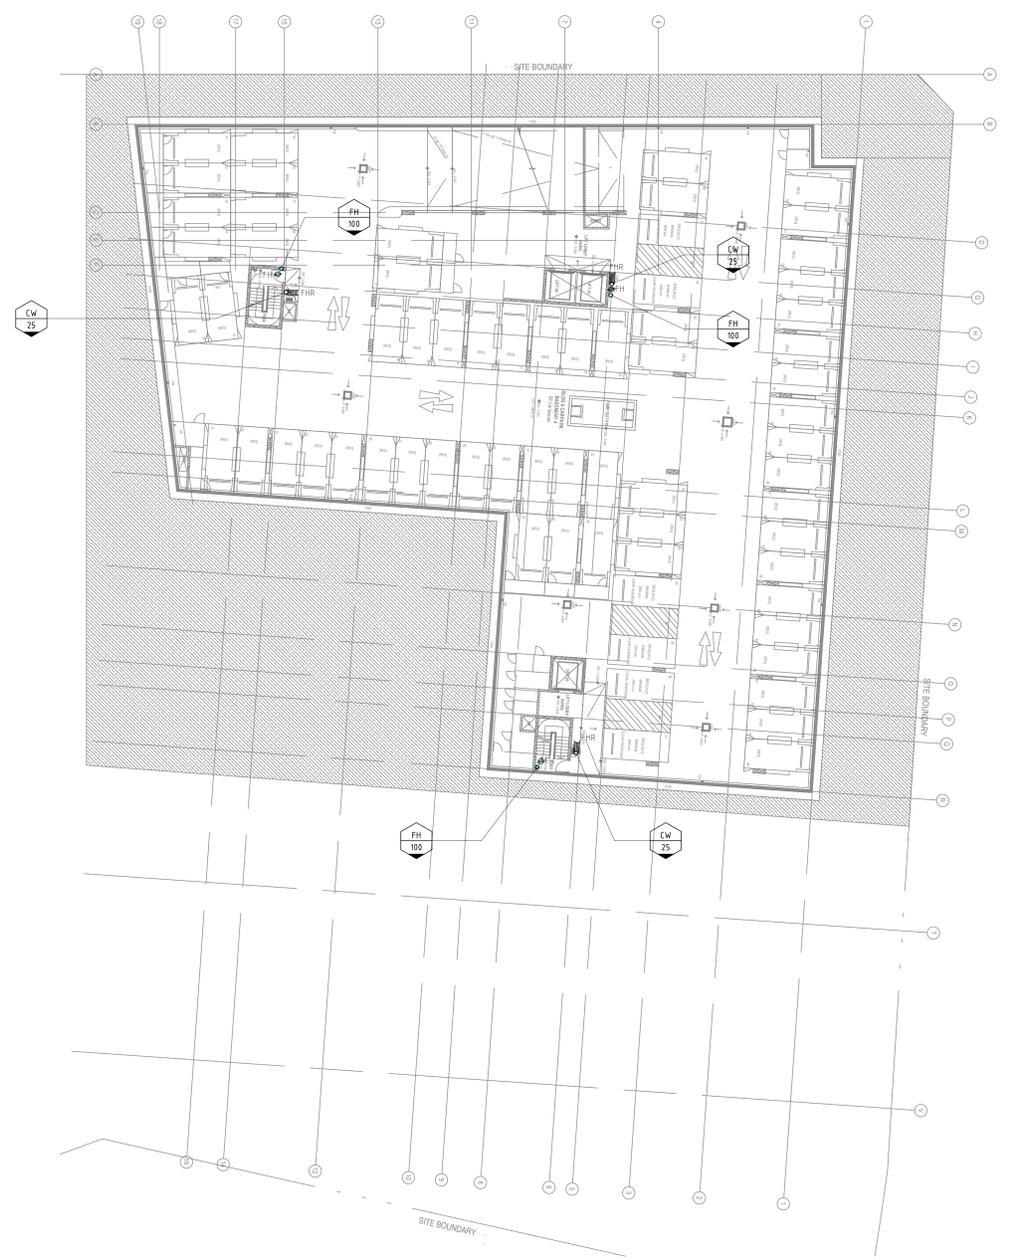

AS BUILT

NOTES		
<p><small>COPYRIGHT OF ALIGN ENGINEERING GROUP. All rights reserved. This drawing may not be reproduced or transmitted in any form, or by any means in part or in whole without permission from ALIGN ENGINEERING GROUP. Figure dimensions shall be taken in preference to scaling. The contractor shall check all dimensions on drawings and site before commencing work.</small></p>		
REVISION		
AB	AS BUILT	20/01/19
ISSUE	AMENDMENT	DATE

ARCHITECT / PROJECT MANAGER

CLIENT



HYDRAULIC & FIRE SERVICES CONSULTANTS



PO BOX 8013
PORT MACQUARIE
NSW 2444
T: 0403 852 312

Email: alan.thomas.aeg@gmail.com ABN2878949310

HYDRAULIC CONTRACTOR



PROJECT

**KINGSTON QUATER
20 NANCARROW AVE
MEADOWBANK NSW 2114**

PROJECT No.	DATE	DRAWN	No. IN SET	SCALE
AEG105	20/01/19	AT		1 TO 200 @ B1

DRAWING TITLE

**HYDRAULIC SERVICES
BASEMENT 4
PRESSURE SERVICES**

DRAWING No.	REVISION
AEG-H19	AB