SERVICES ARE IN THE STRATA UNLESS OTHERWISE NOTED

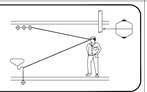

REFERENCE DRAWINGS			
STRUCT			
MECH			
ELEC			
ICP			
ARCH			
DISCIPLINE	DRAWING NUMBER	REV	DATE

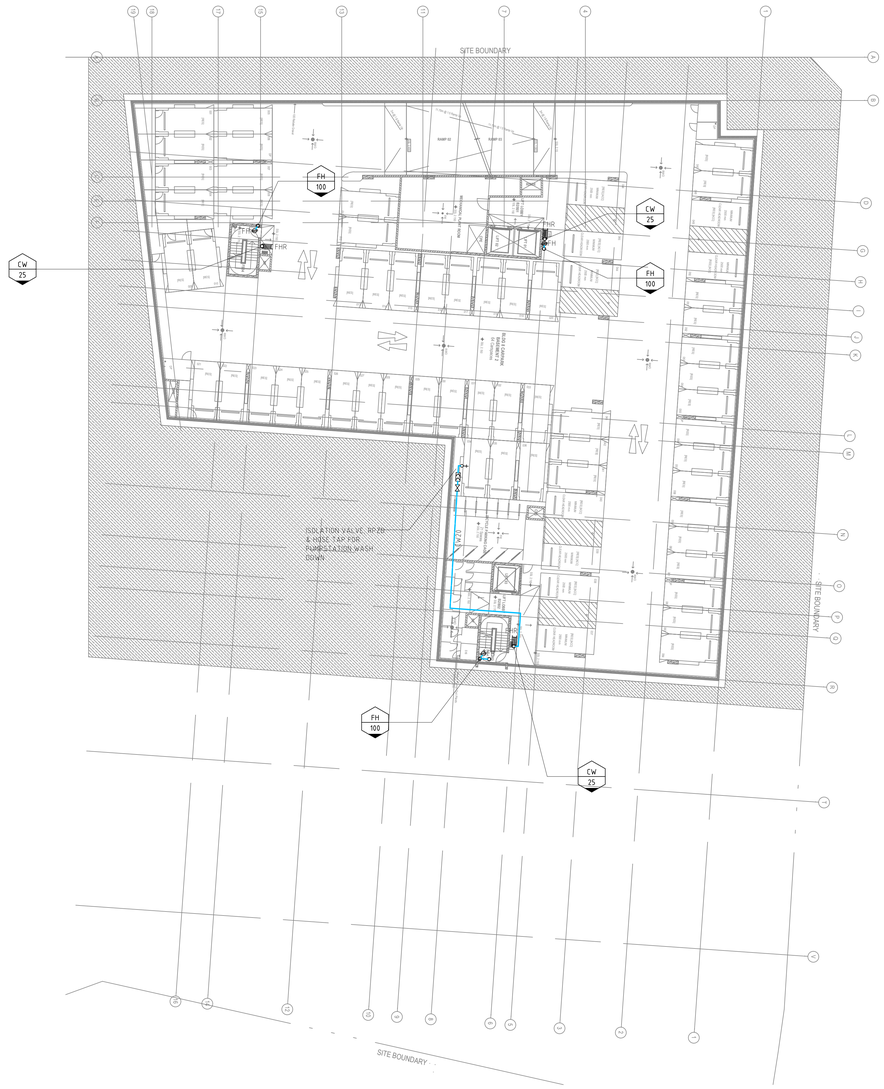

AS BUILT

NOTES

COPYRIGHT OF ALIGN ENGINEERING GROUP. All rights reserved. This drawing may not be re-produced or transmitted in any form, or by any means in part or in whole without permission from ALIGN ENGINEERING GROUP. Figured dimensions shall be taken in preference to scaling. The contractor shall check all dimensions on drawings and site before commencing work.

REVISION

ISSUE	AMENDMENT	DATE
AB	AS BUILT	20 / 01 / 19

ARCHITECT / PROJECT MANAGER

CLIENT

HOLDMARK

HYDRAULIC & FIRE SERVICES CONSULTANTS

ALIGN ENGINEERING GROUP
PO BOX 8013
PORT MACQUARIE
NSW 2444
T: 0403 852 312
Email: alan.thomas.aeg@gmail.com ABN2878949310

HYDRAULIC CONTRACTOR

KWIK FLO group.com.au

PROJECT

KINGSTON QUATER
20 NANCARROW AVE
MEADOWBANK NSW 2114

DRAWING TITLE

HYDRAULIC SERVICES
BASEMENT 2
PRESSURE SERVICES

PROJECT No.	DATE	DRAWN	No IN SET	SCALE	DRAWING No.	REVISION
AEG105	20/01/19	AT		1 TO 200 @ B1	AEG-H21	AB