SERVICES ON THIS DRAWING ARE SHOWN IN THE STRATA (UNLESS NOTED OTHERWISE).

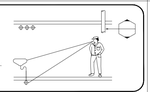

REFERENCE DRAWINGS			
STRUCT			
MECH			
ELEC			
RCP			
ARCH			
DISCIPLINE	DRAWING NUMBER	REV	DATE

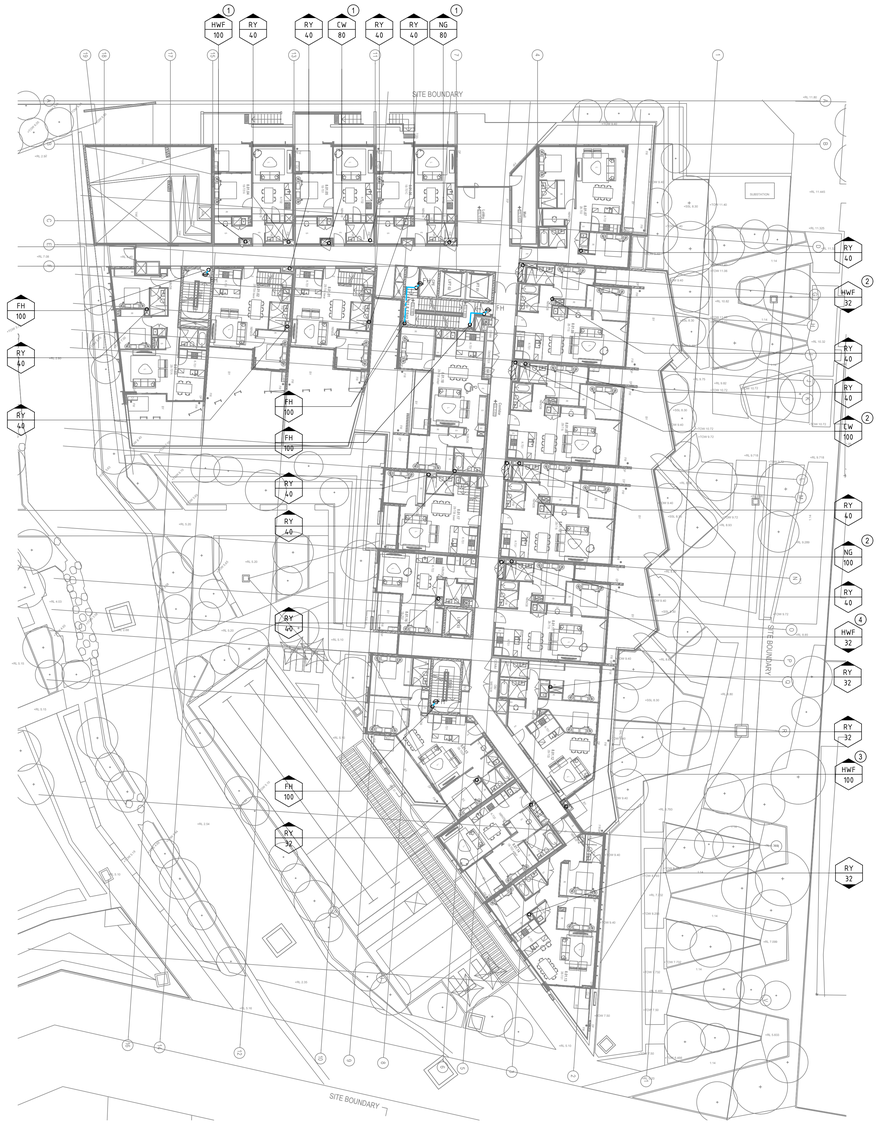

AS BUILT

NOTES

COPYRIGHT OF ALIGN ENGINEERING GROUP. All rights reserved. This drawing may not be re-produced or transmitted in any form, or by any means in part or in whole without permission from ALIGN ENGINEERING GROUP. Figured dimensions shall be taken in preference to scaling. The contractor shall check all dimensions on drawings and site before commencing work.

REVISION		
AB	AS BUILT	20 / 01 / 19
ISSUE	AMENDMENT	DATE

ARCHITECT / PROJECT MANAGER

CLIENT

HOLDMARK
2, 2–4 Giffnock Ave Macquarie Park
NSW 2113
T 02 9889 5540
info@holdmark.com.au

HYDRAULIC & FIRE SERVICES CONSULTANTS

ALIGN ENGINEERING GROUP
PO BOX 8013
PORT MACQUARIE
NSW 2444
T:0403 852 312
Email: alan.thomas.aeg@gmail.com ABN2878949310

LOCATION PLAN

KWIK FLO group.com.au

TRUE NORTH

PROJECT
SHEPHERDS BAY
STAGE 8
NANCARROW AVE
MEADOWBANK N.S.W 2144

DRAWING TITLE
HYDRAULIC SERVICES
LEVEL 1 HIGH LEVEL
PRESSURE SERVICES

PROJECT No.	DATE	DRAWN	No IN SET	SCALE	DRAWING No.	REVISION
AEG105	18/09/2017	AT		1 TO 100 @ A0	AEG-H23	AB